

**GENERAL NOTES**

**F S B**  
**Frankfurt Short Bruza**  
 Architects Engineers Planners  
 5801 Broadway Ext., Suite 500  
 Oklahoma City, Oklahoma 73118  
 Telephone 405 840 2931  
 Facsimile 405 842 7750

**RECORD DRAWING**  
 THIS DRAWING HAS BEEN PREPARED, IN PART, BY OTHERS. WHILE THE INFORMATION IS BELIEVED TO BE CORRECT, THE ARCHITECTS ASSUME NO RESPONSIBILITY FOR THE ACCURACY OF THE INFORMATION. THE ARCHITECTS ASSUME NO RESPONSIBILITY FOR THE ACCURACY OF THE INFORMATION. THE ARCHITECTS ASSUME NO RESPONSIBILITY FOR THE ACCURACY OF THE INFORMATION.

**soh**  
**SRULLA ARCHITECTS**  
 525 South Lincoln, Suite 1000  
 Tulsa, Oklahoma 74103  
 Tel: 918.587.8198  
 Fax: 918.587.0557  
 www.soharchitects.com

**STATE FAIR PARK**  
 OKLAHOMA CITY



**STATE FAIR PARK**  
**Oklahoma City**  
 Barns 4, 5, and 5A

**REVISION HISTORY:**

NO.	DATE	DESCRIPTION

**PROJECT INFORMATION:**

PROJECT NUMBER:	MB-0819
SHEET TITLE:	OVERALL FLOOR PLAN
ISSUE DATE:	OCTOBER 21, 2011
SHEET NUMBER:	AE101

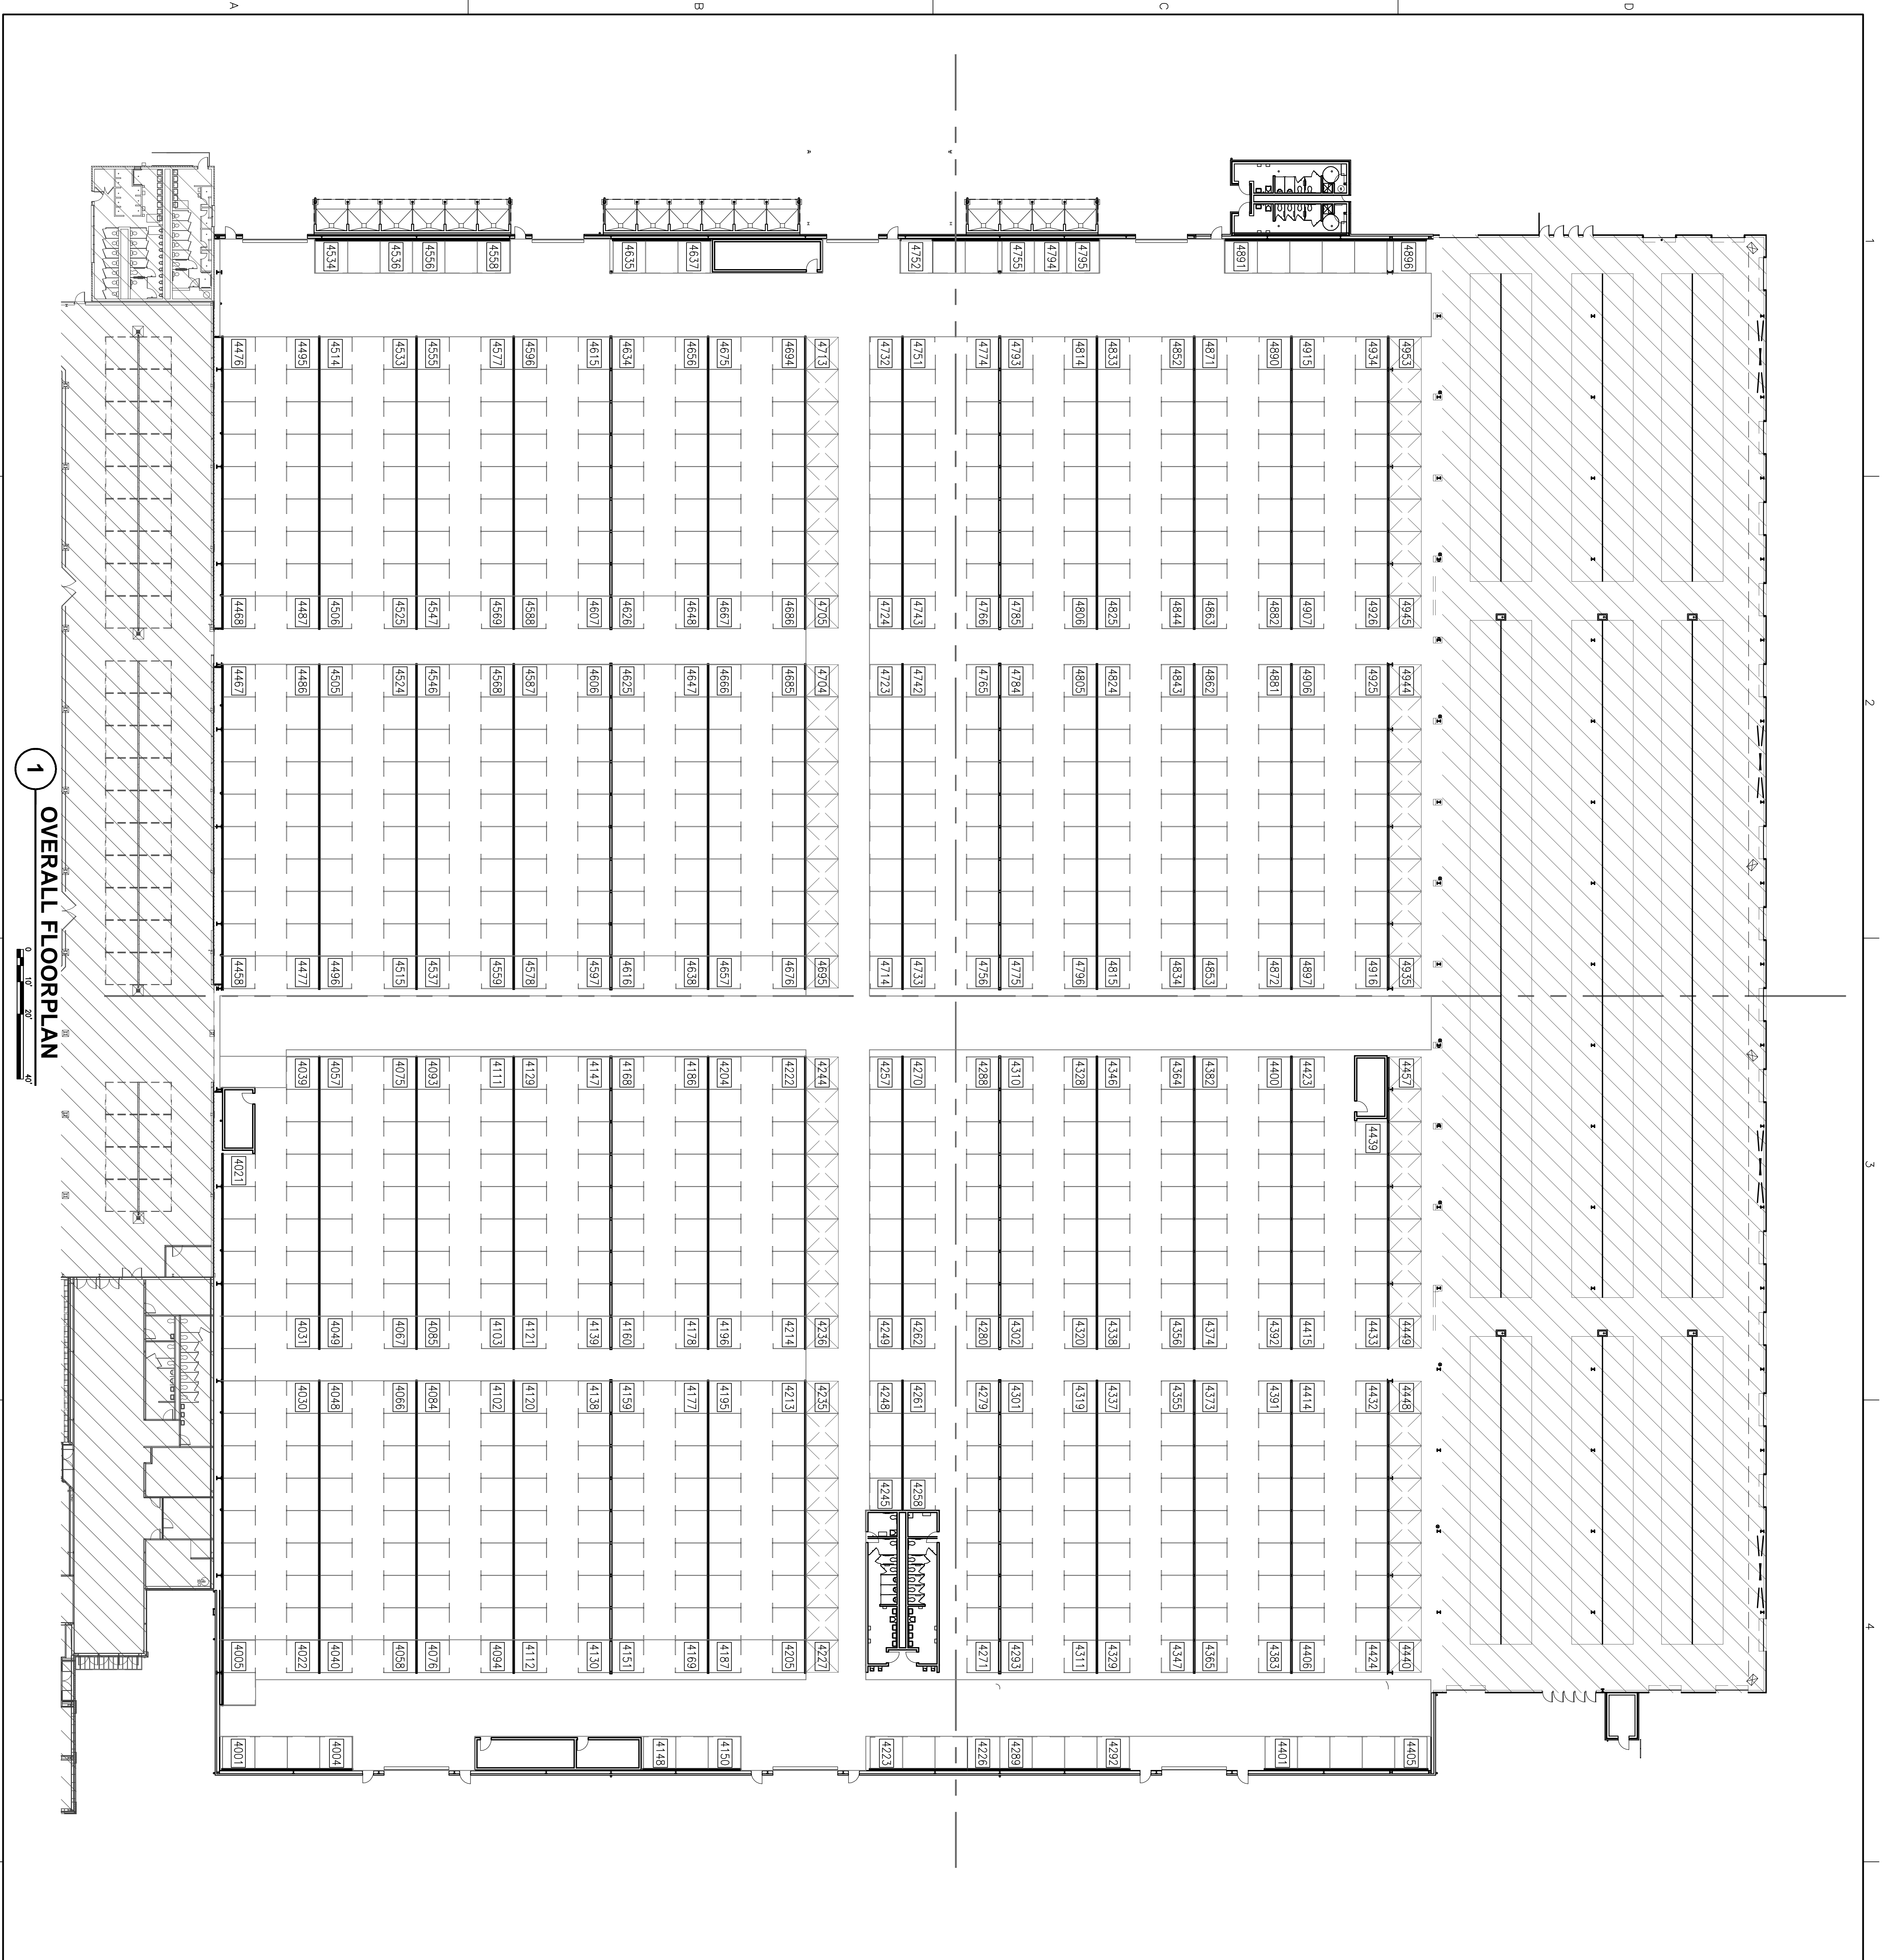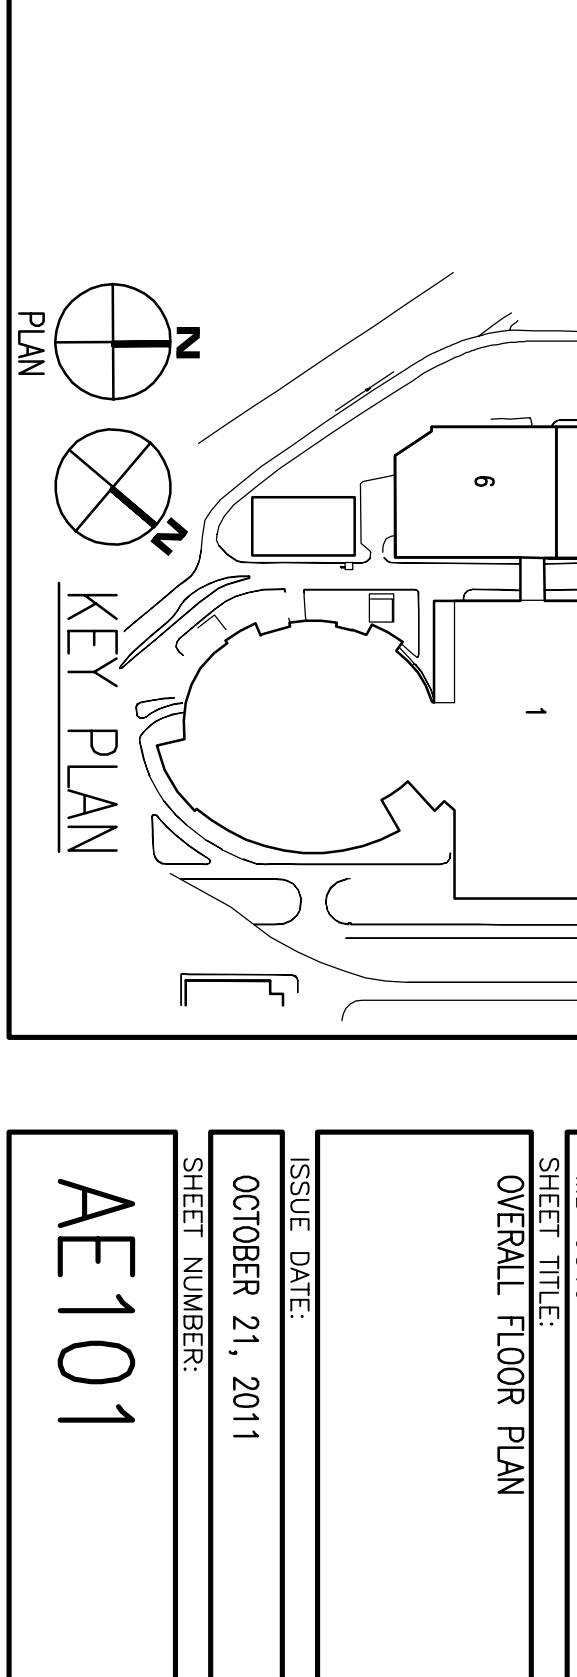

**1 OVERALL FLOOR PLAN**